


THIS DOCUMENT DISCLOSES SUBJECT MATTER IN WHICH LTV ELECTROSYSTEMS, INC. HAS PROPRIETARY RIGHTS. NEITHER RECEIPT NOR POSSESSION THEREOF CONVEYS OR TRANSFERS ANY RIGHT TO REPRODUCE OR DISCLOSE THE DOCUMENT OR ANY PART THEREOF. ANY INFORMATION CONTAINED THEREIN OR ANY PRACTICAL APPLICATION THEREOF IS TO BE KEPT SECRET AND IS TO BE USED ONLY FOR THE PURPOSES OF SERVICE OR TO PRACTICE ANY METHOD OR PROCESS, EXCEPT BY WRITTEN PERMISSION FROM OR WRITTEN AGREEMENT WITH LTV ELECTROSYSTEMS, INC.

REVISIONS		
ZONE/LTR	DESCRIPTION	DATE
A	AS BUILT	11/11

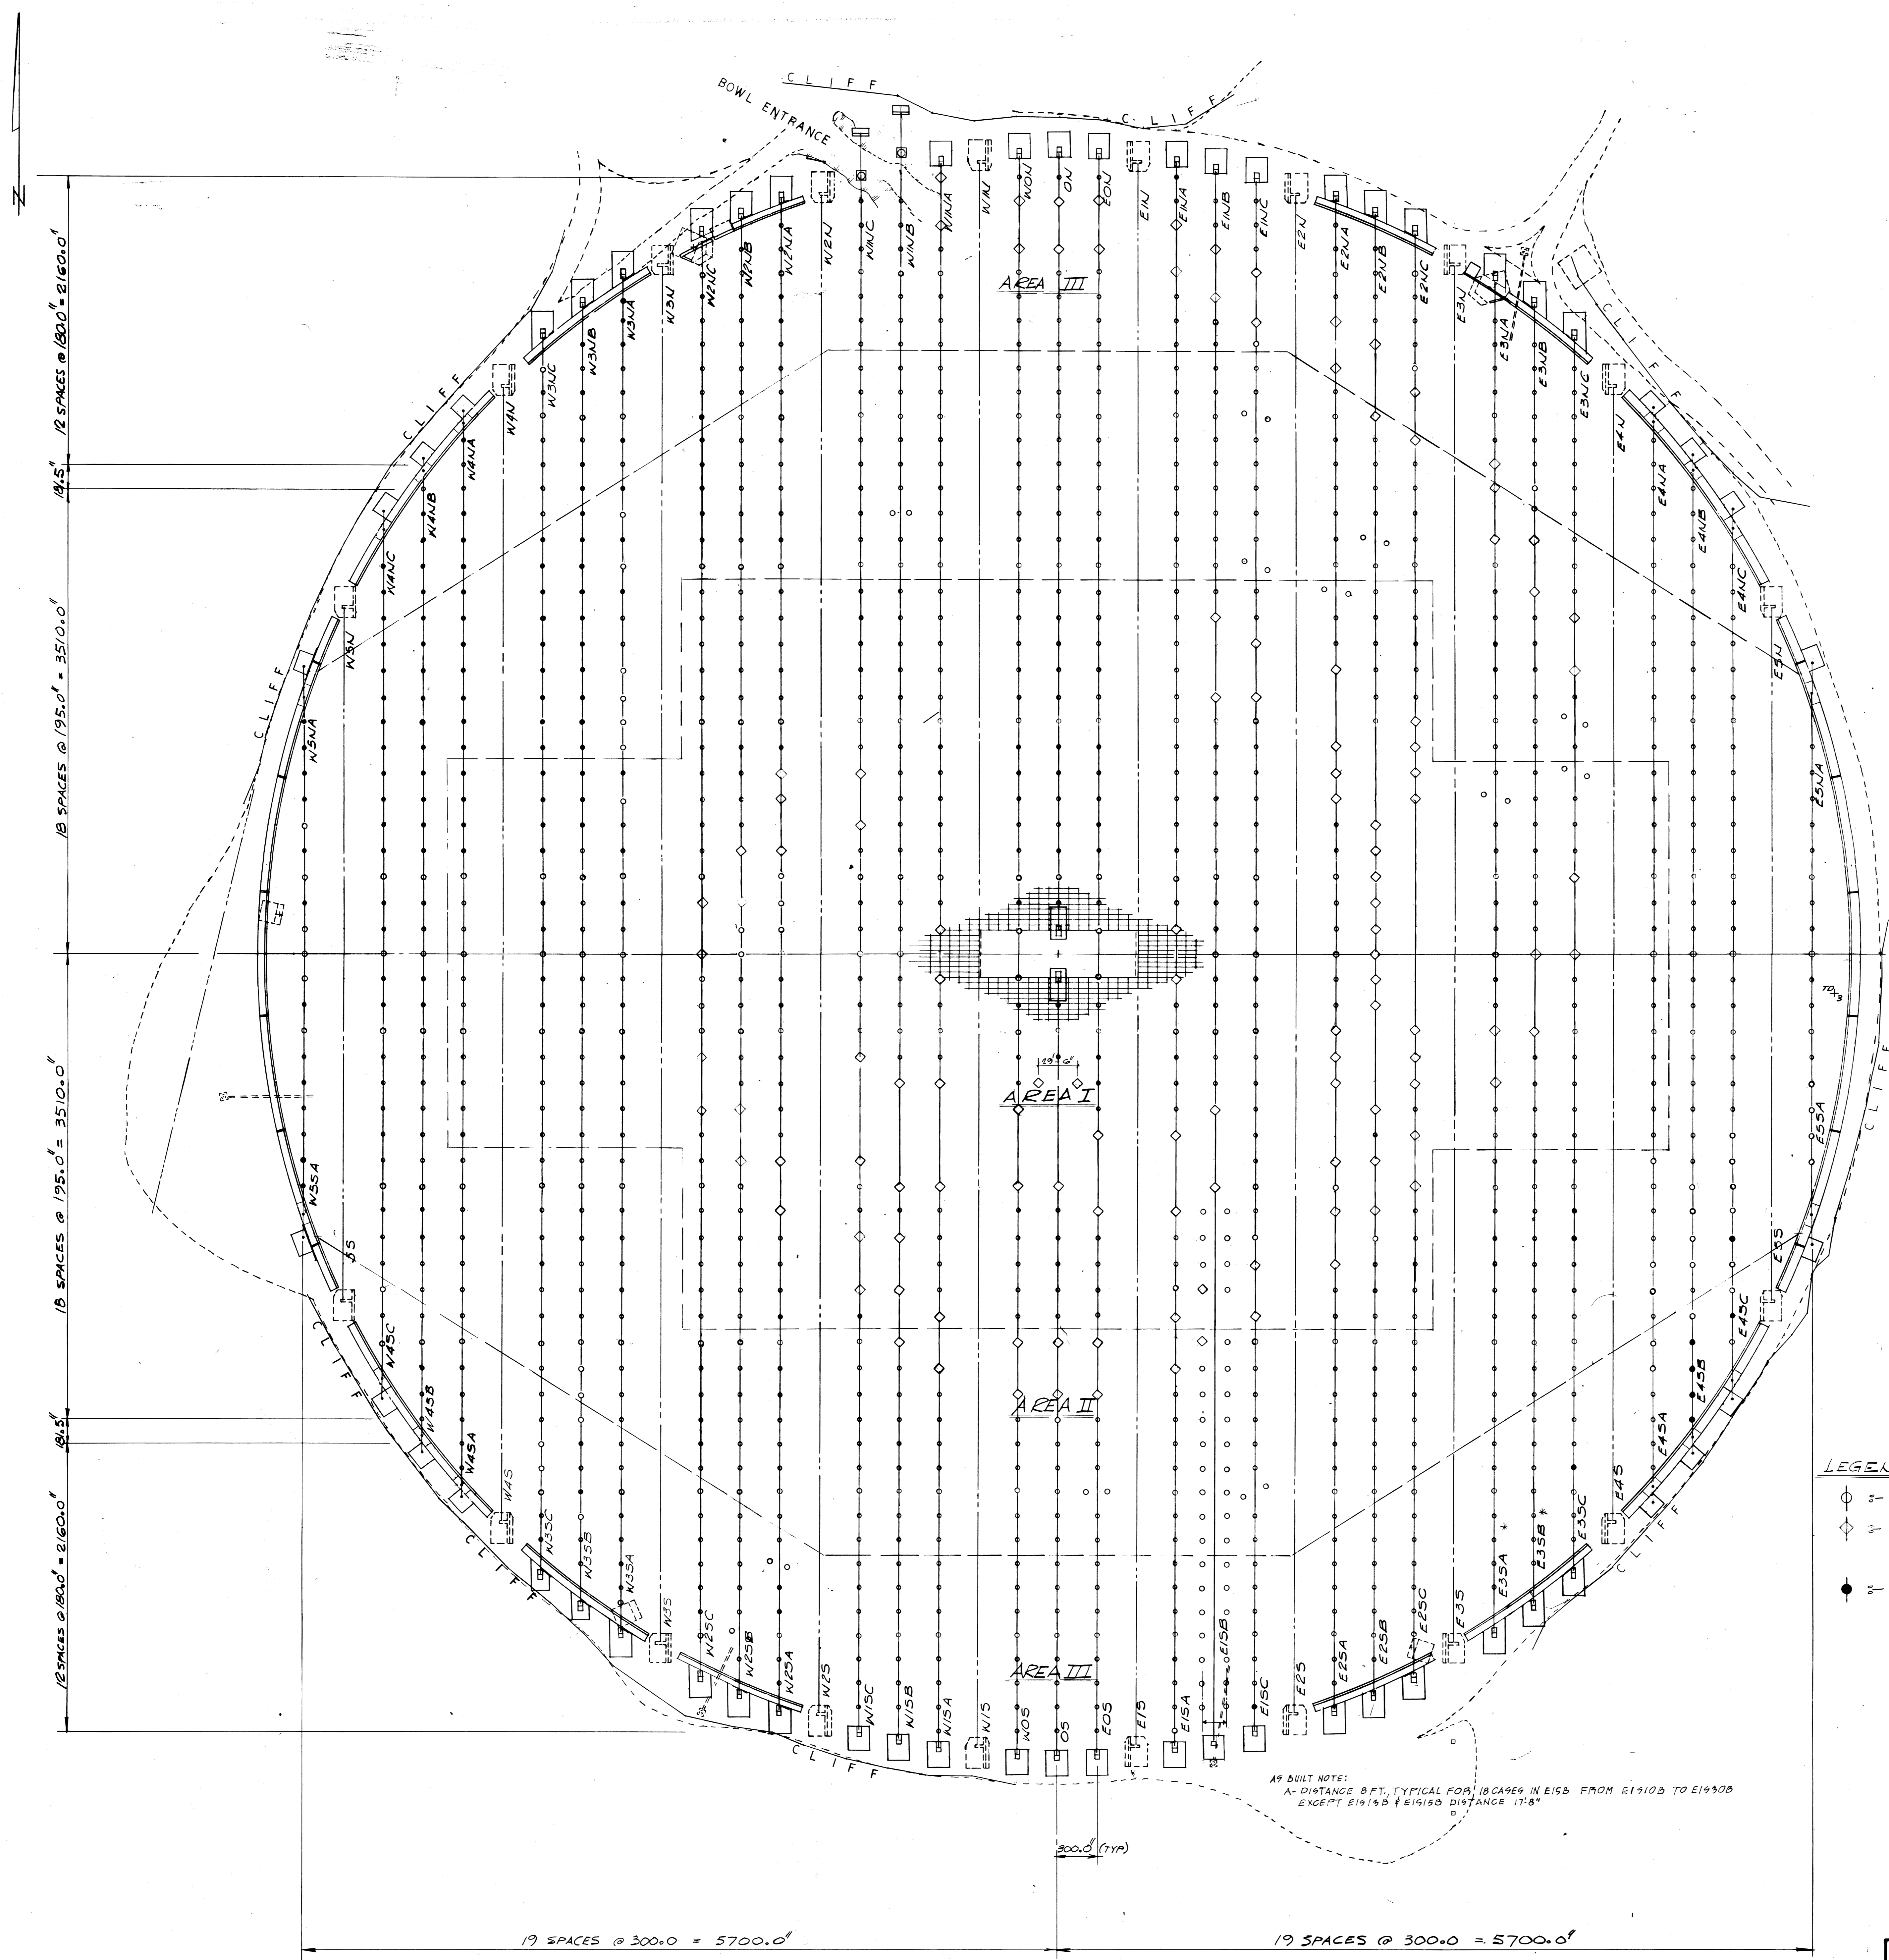

- LEGEND:-
- ⊙ = VERTICAL TIE-DOWN MK "A1"
 - ◇ = VERTICAL TIE-DOWN MK "A2"
 - = CONC. PEDESTAL MK "A4"

AS BUILT NOTE:
 A- DISTANCE 8 FT. TYPICAL FOR 18 CASES IN E15B FROM E1910B TO E1930B
 EXCEPT E1915B & E1915D DISTANCE 11'8"

AS-BUILT

LTV ELECTROSYSTEMS, INC. GARLAND DIVISION P.O. BOX 6118 • DALLAS, TEXAS 75222		SIZE E	CODE IDENT NO. 97871	401-50044
SCALE: NOTED		REV. A	PAGE 30	

401-50044 SH3 A